

O/A PLATE SIZE 210 mm X 185 mm.

## NOTES

'MOODY' TO BE IN 36 pt. TIMES BOLD CAPITALS. N.B. ON SOME PLATES 'SIGMA' WILL BE SUBSTITUTED FOR 'MOODY'; SAME FACE AND POINT SIZE.

'BUILT BY' NOTE TO BE IN 10 pt. UNIVERS 65, UPPER & LOWER, AS SHOWN.

~~WATER PUMP~~


- 1 SHOWER.
- 2 BILGE PUMP.
- 3 COMPASS LIGHT.
- 4 ~~FRIDGE REFRIGERATOR~~
- 5 RIDING LT.
- 6 TRI CON LT.
- 7 INSTUMENTS
- 8 ~~F/WATER PUMP~~. F/W PUMP

LABELS FOR M41  
ELECTRIC VENT.

9 KEEL

~~WATER PUMP~~

~~WATER PUMP~~

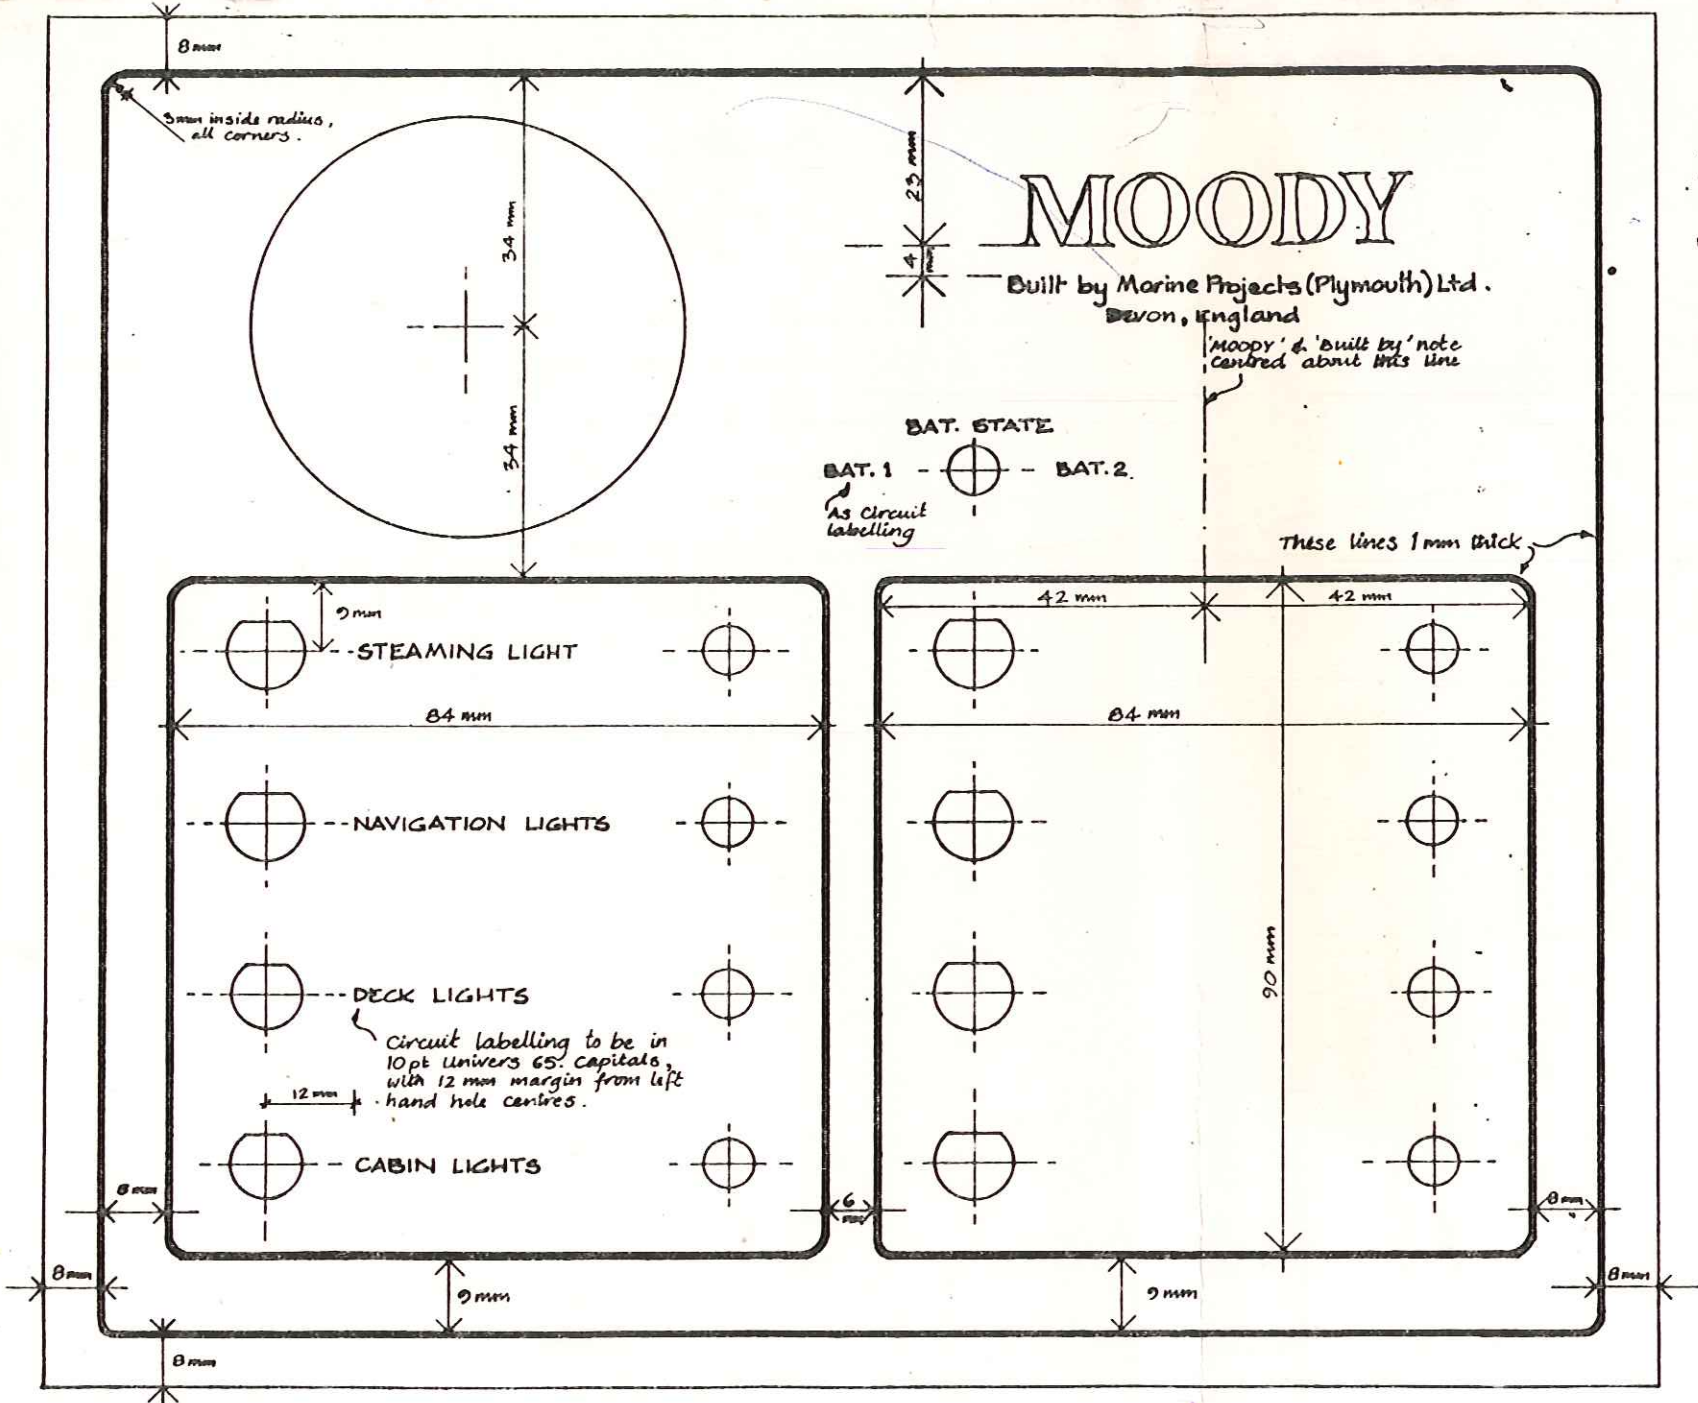

O/A PLATE SIZE 210 mm X 185 mm.

NOTES

- 'MOODY' TO BE IN 36 pt. TIMES BOLD CAPITALS. N.B. ON SOME PLATES 'SIGMA' WILL BE SUBSTITUTED FOR 'MOODY'; SAME FACE AND POINT SIZE.
- 'BUILT BY' NOTE TO BE IN 10 pt. UNIVERS 65, UPPER & LOWER, AS SHOWN.

W/PUMP?

SHOWER.

ENGINE PUMP

COMPASS LIGHT.

FRIDGE

RIDING LT.

TRI COU LT

INSTRUMENTS

ENG ROOM LT

FRESH WATER PUMP

5 - 5 A.

3 - 15 A

2 - 10

LIFTING KEEL

f 139.60 for 200

e MOODY 30 WINDOW. (TYPICAL SECTION)

Material PERSPEX

Drawn by E.C.T.

Date MAY. 77.

Scale NOT TO SCALE

Drwg. NO M30 - 098

MARINE PROJECTS PLYMOUTH LTD  
Newport Street, Plymouth. Telephone

